



St Hildas School Plan

Lower Ground Floor

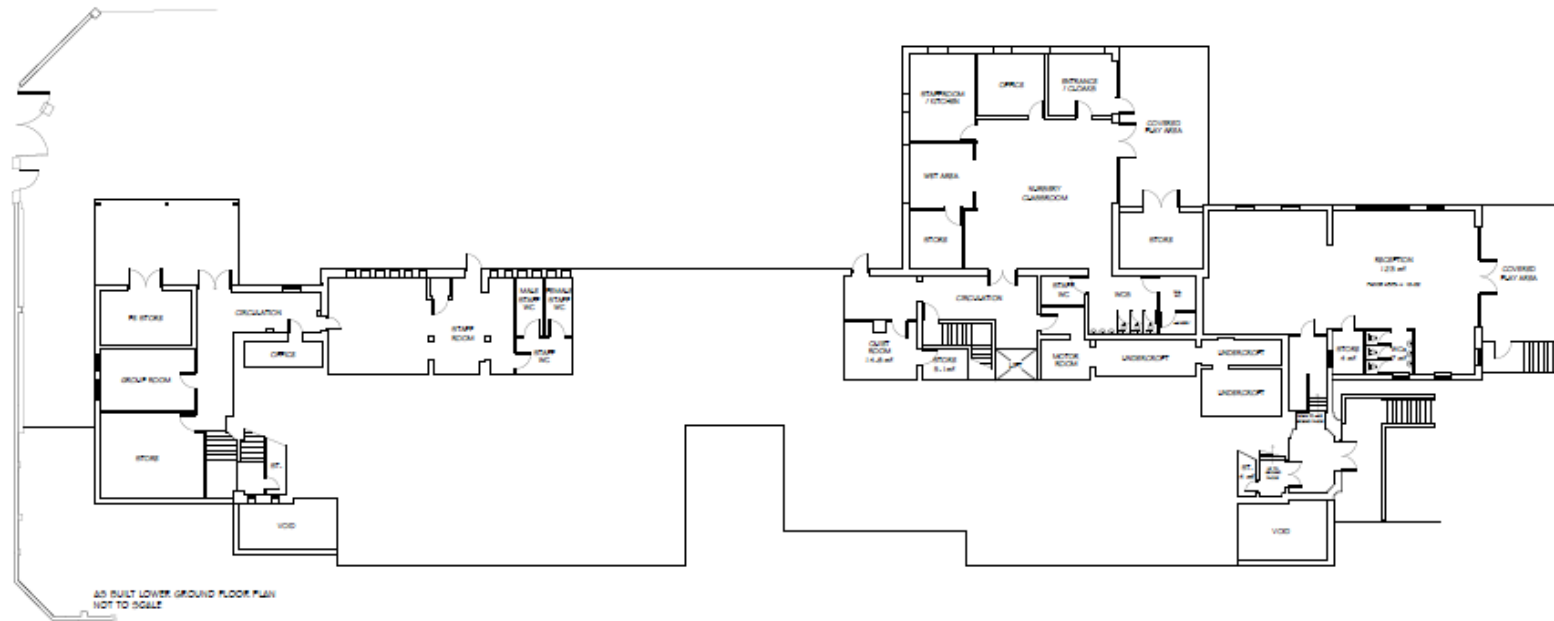

Ground Floor

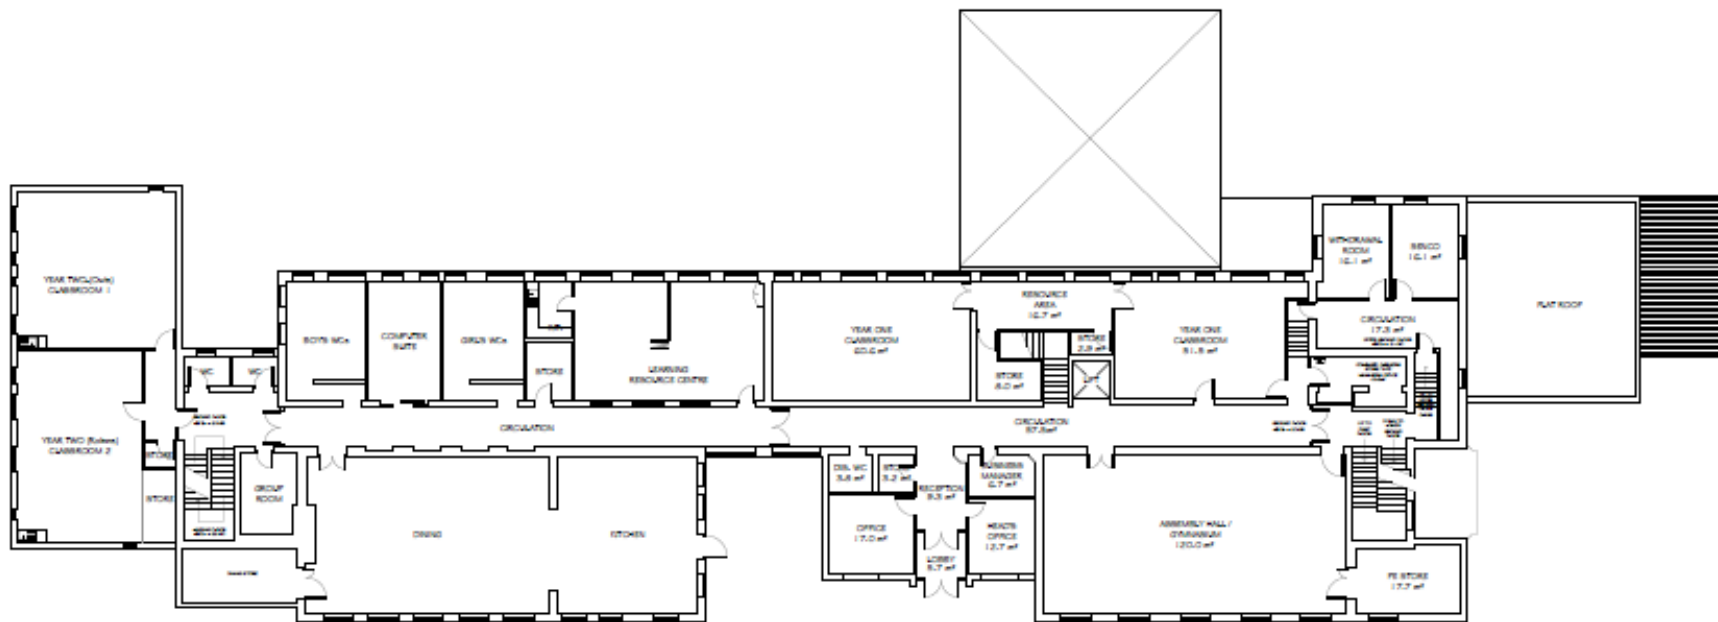

AS BUILT GROUND FLOOR PLAN
SCALE 1:200 = AS

First Floor

